

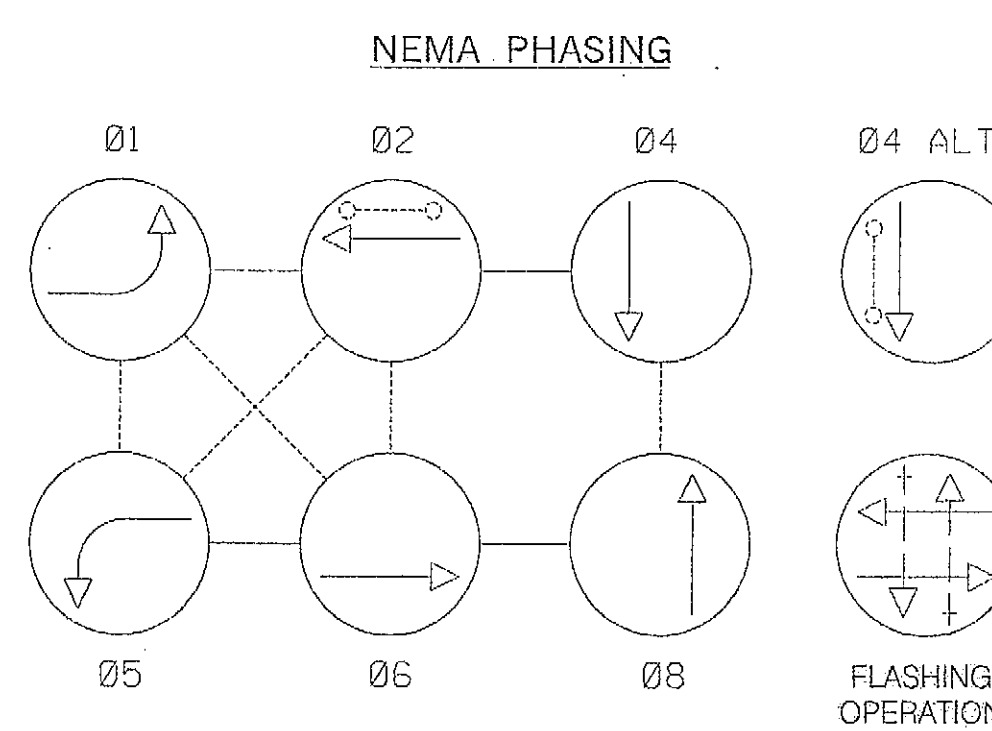
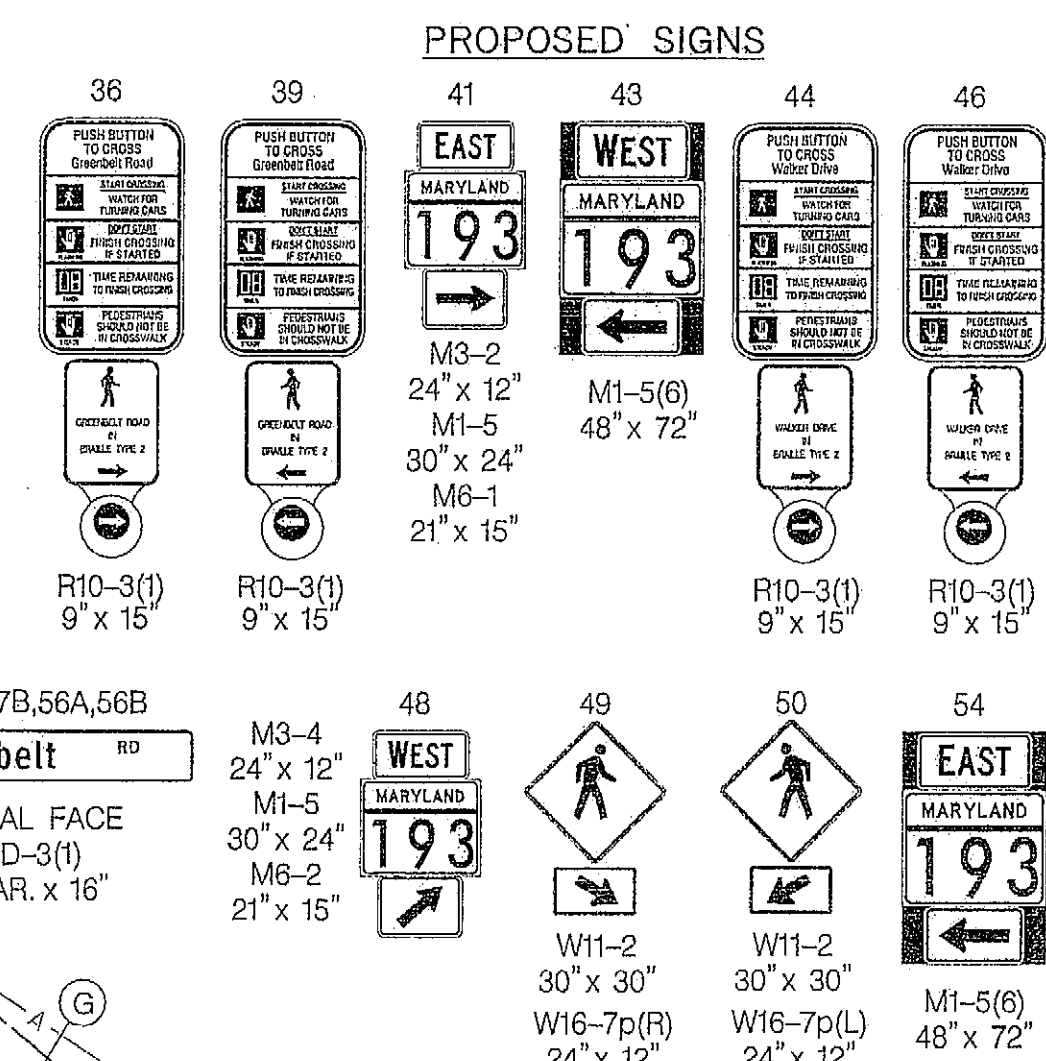
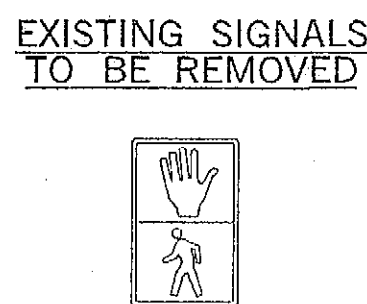
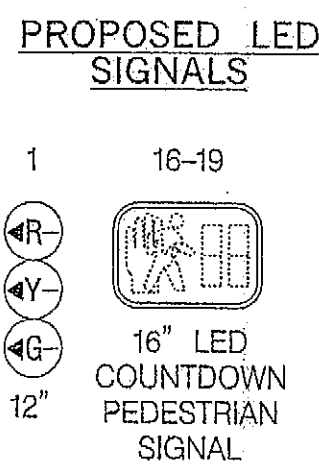
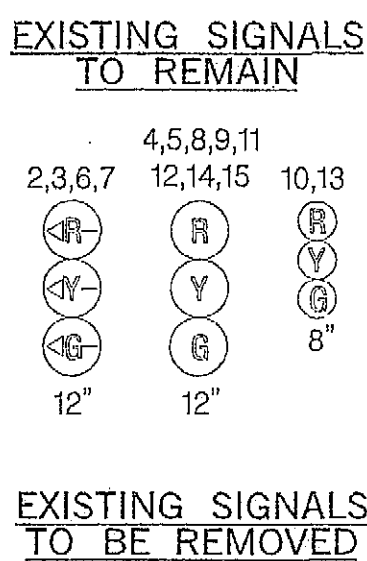


MD 193 IS ASSUMED TO RUN IN AN EAST/WEST DIRECTION

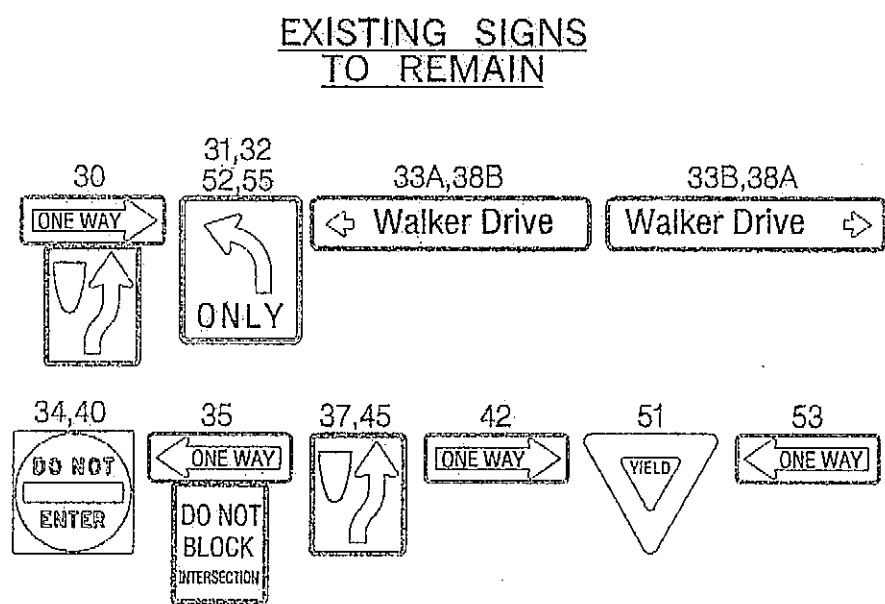

PHASES ASSOCIATED BY A DASHED LINE WILL OPERATE CONCURRENTLY.

PHASES ASSOCIATED BY A SOLID LINE WILL NOT OPERATE CONCURRENTLY.

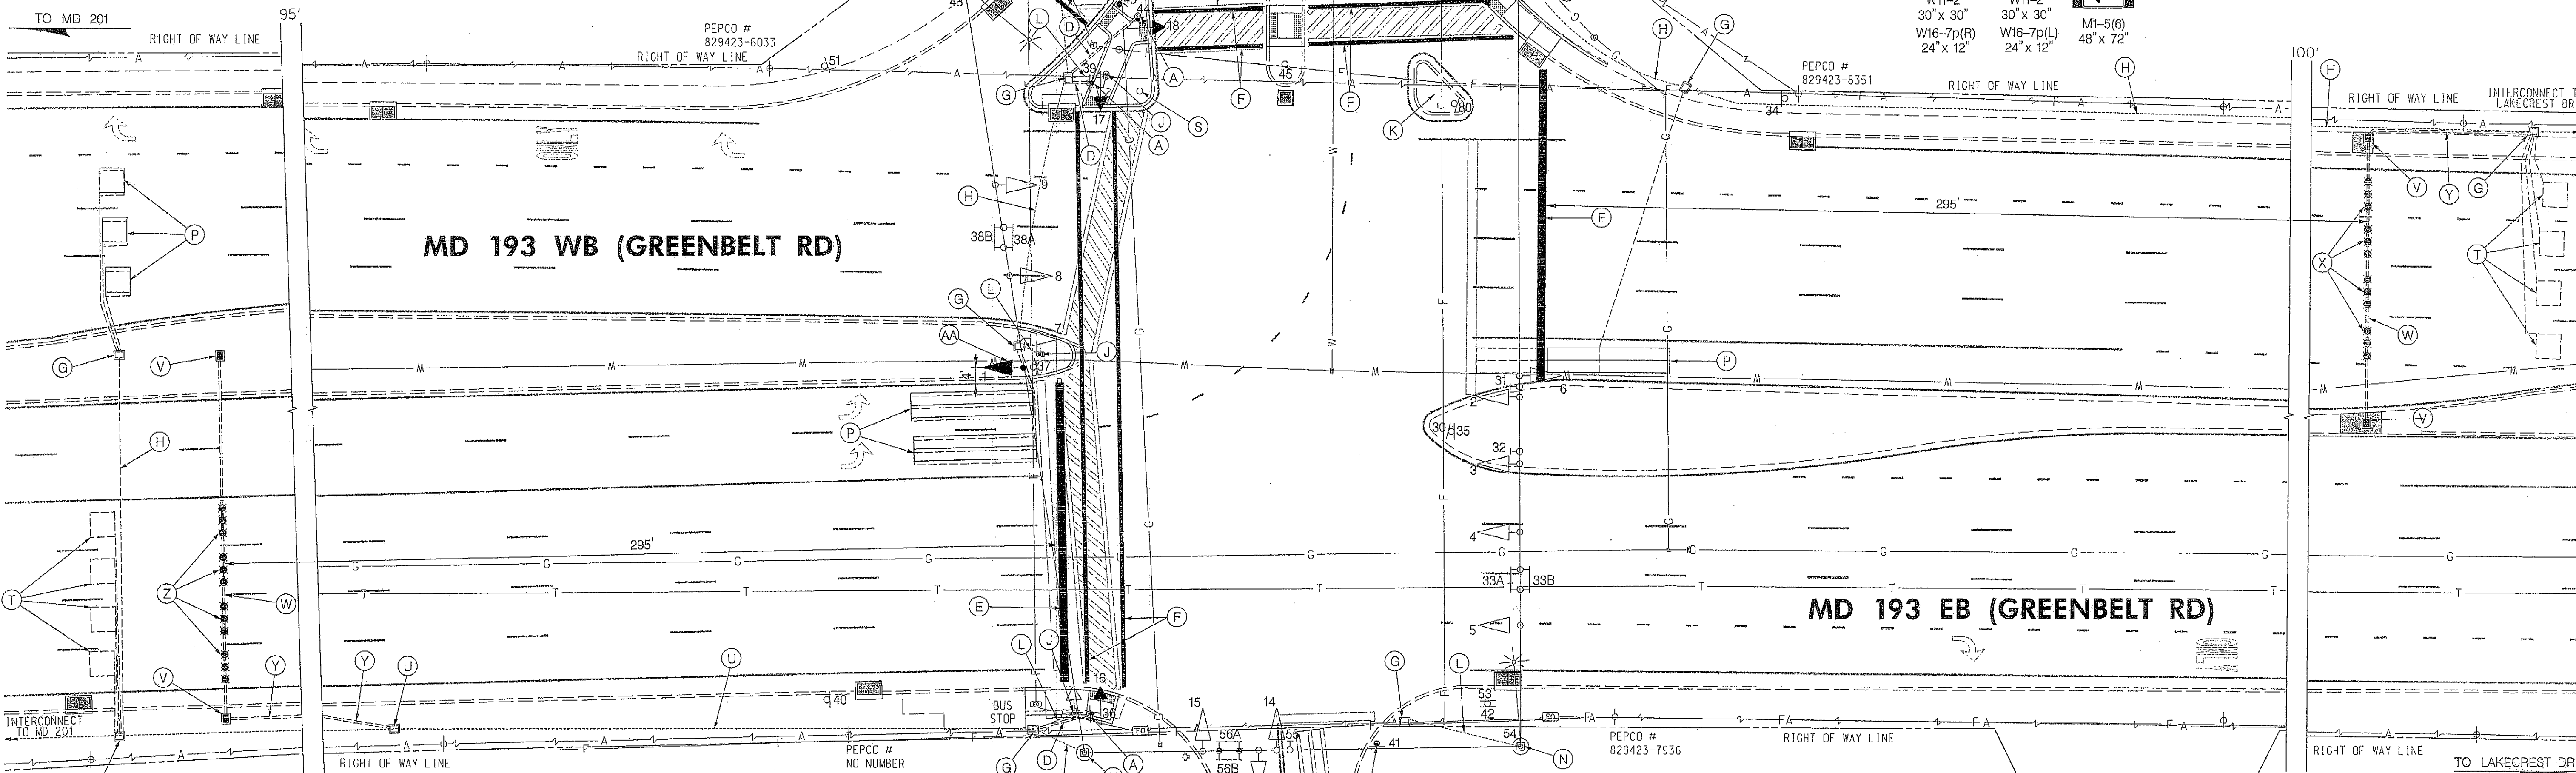

GENERAL NOTES:

1. THE CONTRACTOR SHALL VERIFY ALL PROPOSED POLE AND CABINET LOCATIONS PRIOR TO INSTALLATION.
2. THE CONTRACTOR SHALL INVENTORY PAVEMENT MARKINGS BEFORE GRINDING, OTHER THAN THOSE DETAILED ON THE PLAN. ALL PAVEMENT MARKINGS SHALL BE INSTALLED IN ACCORDANCE WITH SHA STANDARDS.
3. SHA FORCES SHALL REMOVE THE CONTROLLER AND ALL AUXILIARY EQUIPMENT FROM THE CONTROLLER CABINET. ALL OTHER EXISTING SIGNAL EQUIPMENT REMOVED SHALL BECOME THE PROPERTY OF THE SIGNAL CONTRACTOR UPON COMPLETION OF THE SIGNAL.
4. THE CONTRACTOR SHALL BE RESPONSIBLE FOR TERMINATING ALL SIGNAL CABLE TO THE APPROPRIATE TERMINALS AND PROPERLY LABEL EACH CABLE.
5. THE CONTRACTOR SHALL VERIFY ALL UNDERGROUND UTILITIES PRIOR TO INSTALLING PROPOSED SIGNAL EQUIPMENT. IF ANY UTILITY CONFLICTS SHOULD ARISE THE CONTRACTOR SHALL CONTACT THE PROJECT ENGINEER.
6. ALL TRAFFIC SIGNAL FOUNDATIONS SHALL BE INSTALLED AT THE FINAL SIDEWALK OR CURB GRADE FOR CLOSED SECTIONS, HIGHEST ROADWAY PROFILE GRADE FOR OPEN SECTIONS, TO MEET CLEARANCES AS SPECIFIED IN MD 816.03, MD 818.01, MD 818.02, MD 818.04. THE CONTRACTOR SHALL VERIFY ULTIMATE GRADES PRIOR TO THE INSTALLATION OF ALL SIGNAL EQUIPMENT.
7. THE CONTRACTOR SHALL CONTACT ED RODENHIZER AT THE SIGNAL SHOP (410) 787-7650 TO DELIVER APS EQUIPMENT FOR TESTING.
8. THE CONTRACTOR SHALL WORK ONE QUADRANT AT A TIME AND MAINTAIN PEDESTRIAN ACCESSIBILITY TO ALL OTHER QUADRANTS.
9. SEE SHEET 2 FOR CROSS WALK HATCHING.
10. USE EXISTING METER RUN NEW 3 WIRE 1 CONDUCTOR ELECTRICAL CABLE TO NEW BASE CABINET THROUGH 2" CONDUIT WITH RISER.

REDLINE 1

ADDITION OF SIGNAL TO PROJECT PG8925177

SHA

STATE OF MARYLAND
DEPARTMENT OF TRANSPORTATION
STATE HIGHWAY ADMINISTRATION
OFFICE OF TRAFFIC & SAFETY
TRAFFIC ENGINEERING DESIGN DIVISION
MD 193 (GREENBELT RD) AND
WALKER DRIVE
GREENBELT, MD

SIGNALIZATION PLAN SHEET

SCALE 1" = 20' ADVERTISED DATE 1-25-88 CONTRACT NO. OT-3-88

DESIGNED BY COUNTY PRINCE GEORGE'S
DRAWN BY J. GREEZICKI LOGMILE 16019306.11
CHECKED BY D. DODA TIMS NO.
F.A.P. NO. TOD NO.

TS NO. 2493C DRAWING SG-1 OF 2 SHEET NO. 16 OF 26

APPROVALS	REVISIONS
TEAM LEADER	09/12 TMS-L274 SHA NO. PG8925177 INSTALL APS/CPS
ASST. DIV. CHIEF	CW M.F. 10-03-91 B. INSTALL EXCLUSIVE LEFT-TURN PHASING
DIVISION CHIEF	NWL 01-01-97 AW-102-501-385 A. INSTALL STREET LIGHTS, PED INDICATIONS AND CROSSWALK ON WB OF 193
OFFICE DIRECTOR	

BAI

BRUDIS & ASSOCIATES, INC.
Consulting Engineers
9240 Rummey Road, Suite 110
Columbia, Maryland 21046
Phone: 410-884-3807
www.brudis.com

PLOTTED: Tuesday, November 13, 2012 AT 03:11 PM
FILE: P:\09-002 TEDD\Task 84 MD 193 Rhode Island Ave to Southway\Drawings\CADD\Working\MD193@Walker\pSG-P001_MD193@Walker.dgn